DWG NO: 2636-06-48953

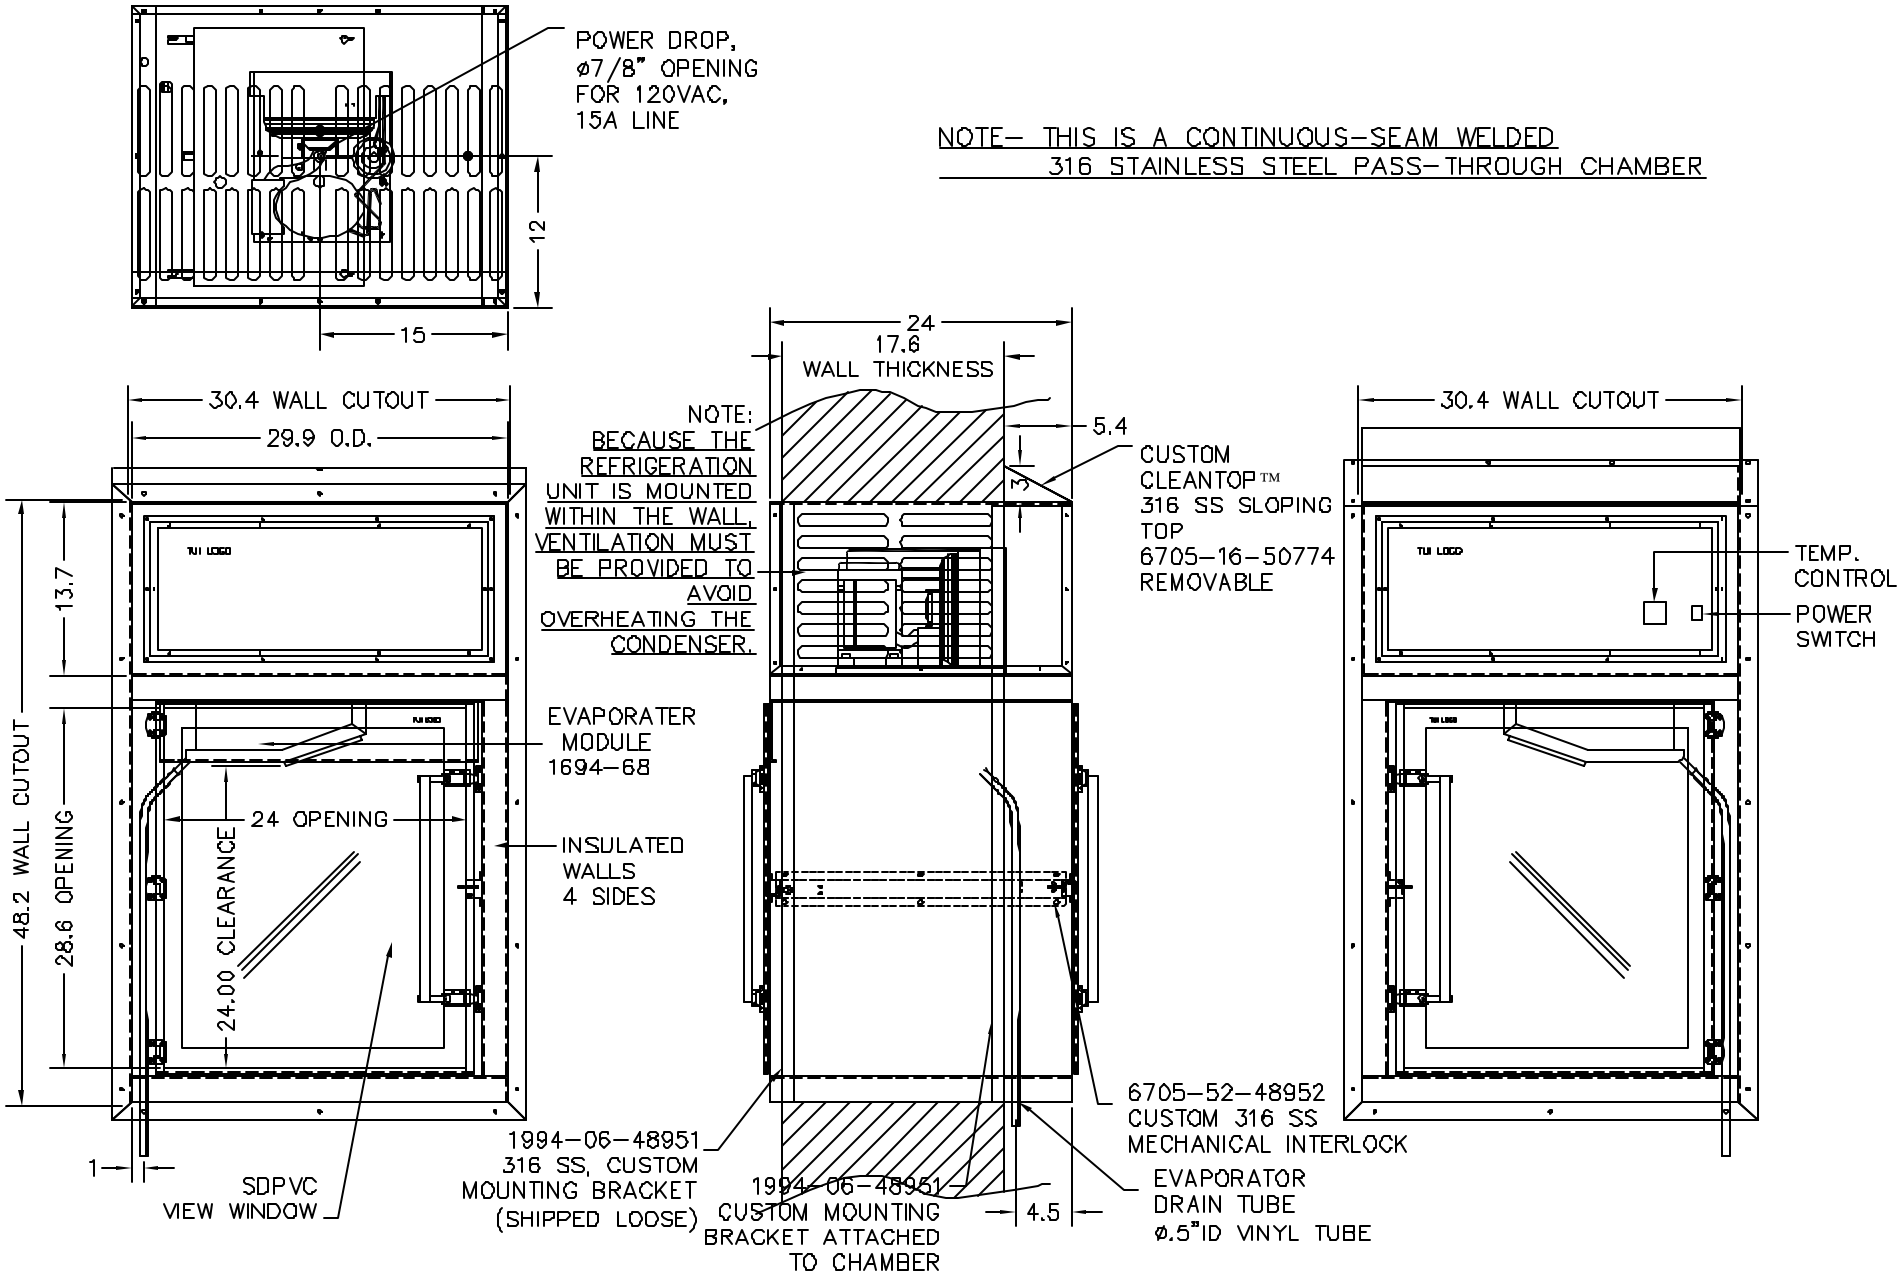

LTR	DESCRIPTION	DATE	APPD
NC	INITIAL RELEASE		
A	REVISED TO AS BUILT	02.01 06	EDT

-1	
CONFIG	DESCRIPTION
MATERIAL SPEC. 316 STAINLESS STEEL	FINISH SPEC.

UNLESS OTHERWISE SPECIFIED, DIMENSIONS ARE IN INCHES
TOLERANCES ON
.XX DECIMALS ± .08 X°±
.XXX DECIMALS ± X/X ±

SIGNATURES		DATE
DRAWN:	JOSE SORIANO	12.06.05
ENGR	TUCKER	

Terra Universal

PROPRIETARY & CONFIDENTIAL ALL RIGHTS RESERVED BY TERRA UNIVERSAL DISCLOSURE OR COPYING PROHIBITED

TITLE CUSTOM PASS THROUGH 316 SS, WALL MOUNTED 24"W x 24"D x 24"H

NEXT ASSY	USED ON	SCALE	
	130823	NONE	PASS THROUGH

A 2636-06-48953

SHEET 1 OF 13